


### Main Floor

SCALE: 1/8" = 1'-0"

- INDICATES ROOM NUMBERS
- INDICATES DOOR NUMBER
- INDICATES WINDOW NUMBER



### AS-BUILT PLAN

DATE: MAY 08

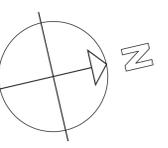

### WALL CONSTRUCTION TYPES

- TYPE 1: 0.5" SHEATHING, 2" x 6" WOOD STUD, 2" DRYWALL
- TYPE 2: 20#-6 STEEL STUD, 2" DRYWALL EACH SIDE
- TYPE 3: 2" TYPE X DRYWALL @ MECH/ELEC RIMS
- TYPE 4: 2" TYPE X DRYWALL @ MECH/ELEC RIMS
- TYPE 5: 2" TYPE X DRYWALL @ MECH/ELEC RIMS
- TYPE 100: 2" TYPE X DRYWALL @ MECH/ELEC RIMS

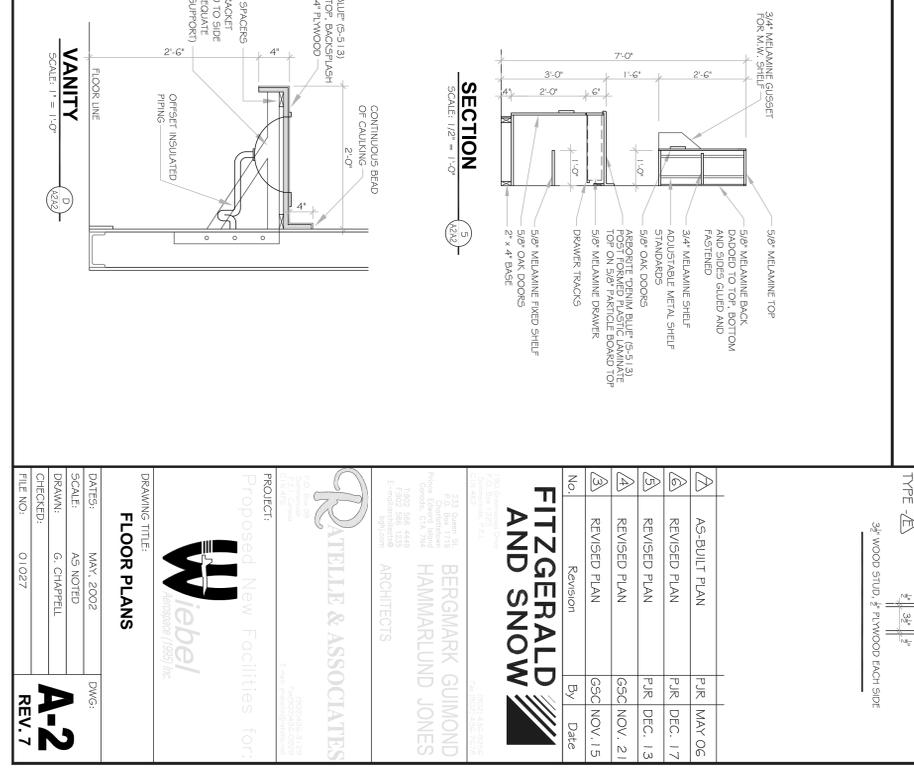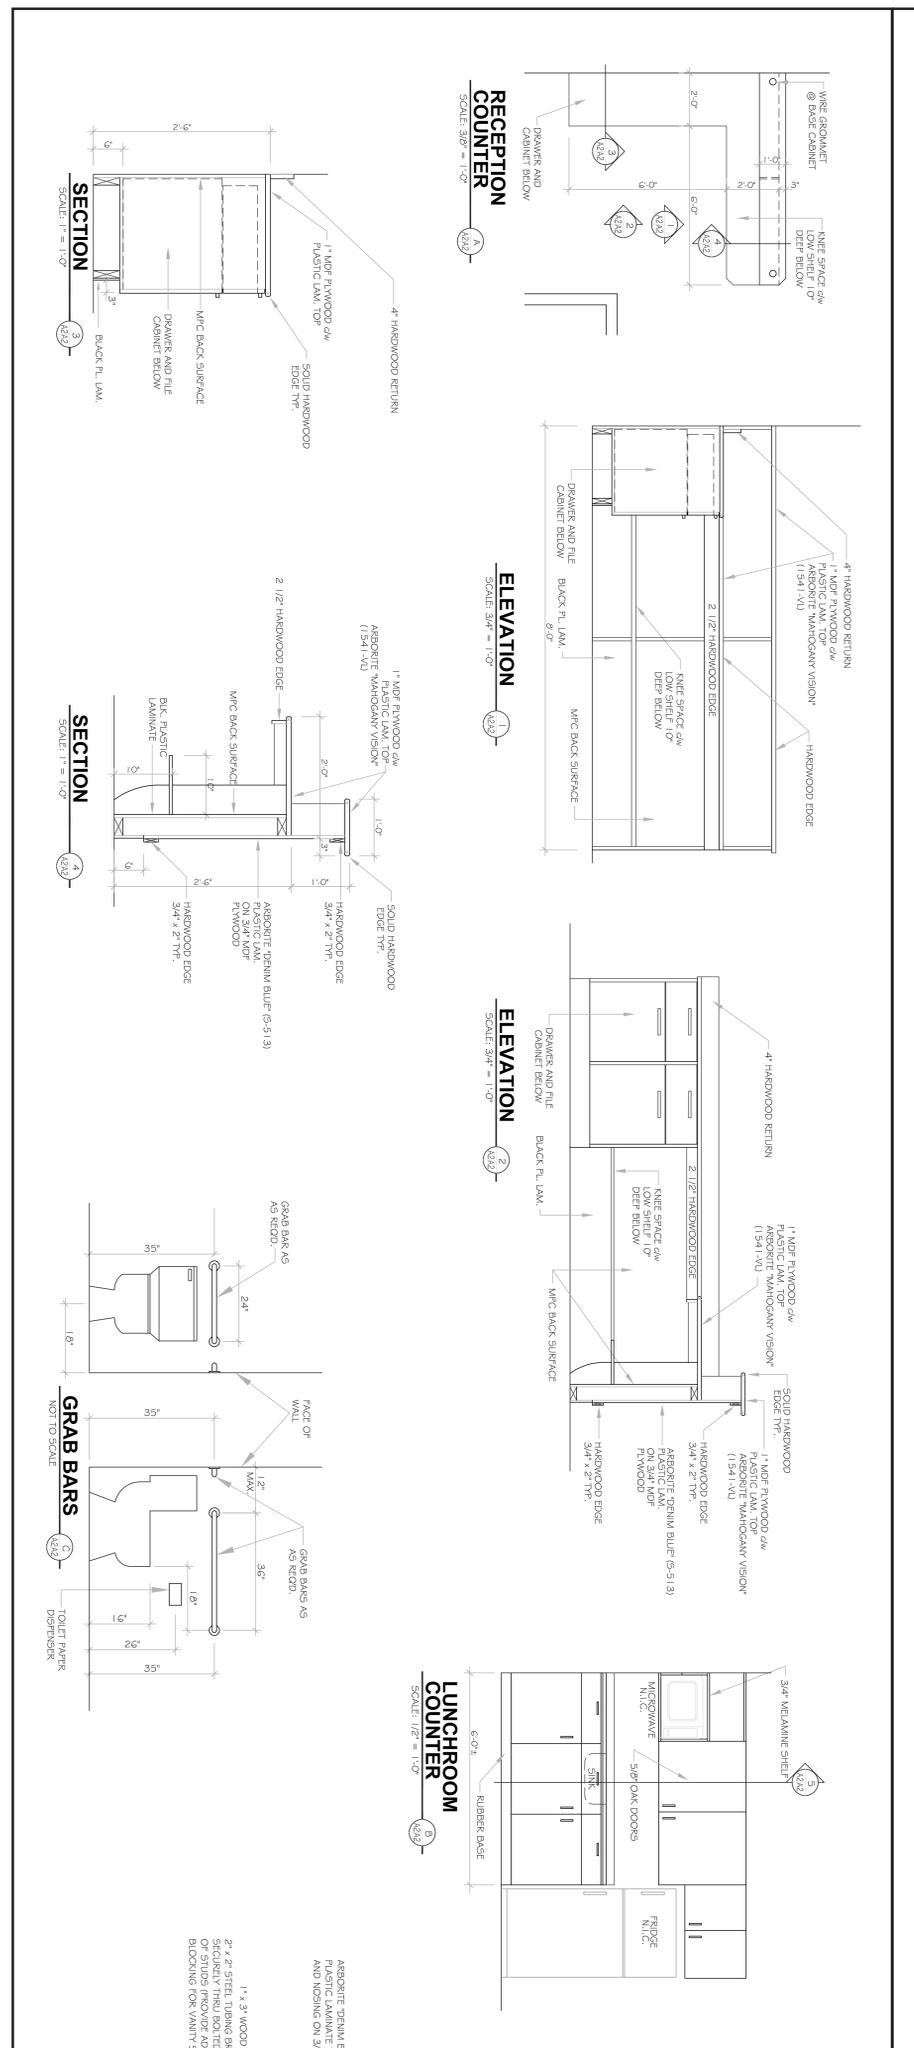

No.	Description	Revision	By	Date
1	AS-BUILT PLAN		PR	MAY 08
2	REVISED PLAN		PR	DEC 17
3	REVISED PLAN		PR	DEC 13
4	REVISED PLAN		GS	NOV 21
5	REVISED PLAN		GS	NOV 15

**FITZGERALD AND SNOW**

BERGMARK GUIMOND  
HAMMARLUND JONES

ARCHITECTS

**RATHELLE & ASSOCIATES**

Proposed New Facilities for

**W** **Rebel**

ARCHITECTS

PROJECT: Proposed New Facilities for

DATE: MAY 2002

SCALE: AS NOTED

DRAWN: G. CHAPPEL

CHECKED: G. CHAPPEL

FILE NO: 01027

DRAWING TITLE: FLOOR PLANS

DWG: A-2

REV: 7